


SIERNINGERSTRASSE

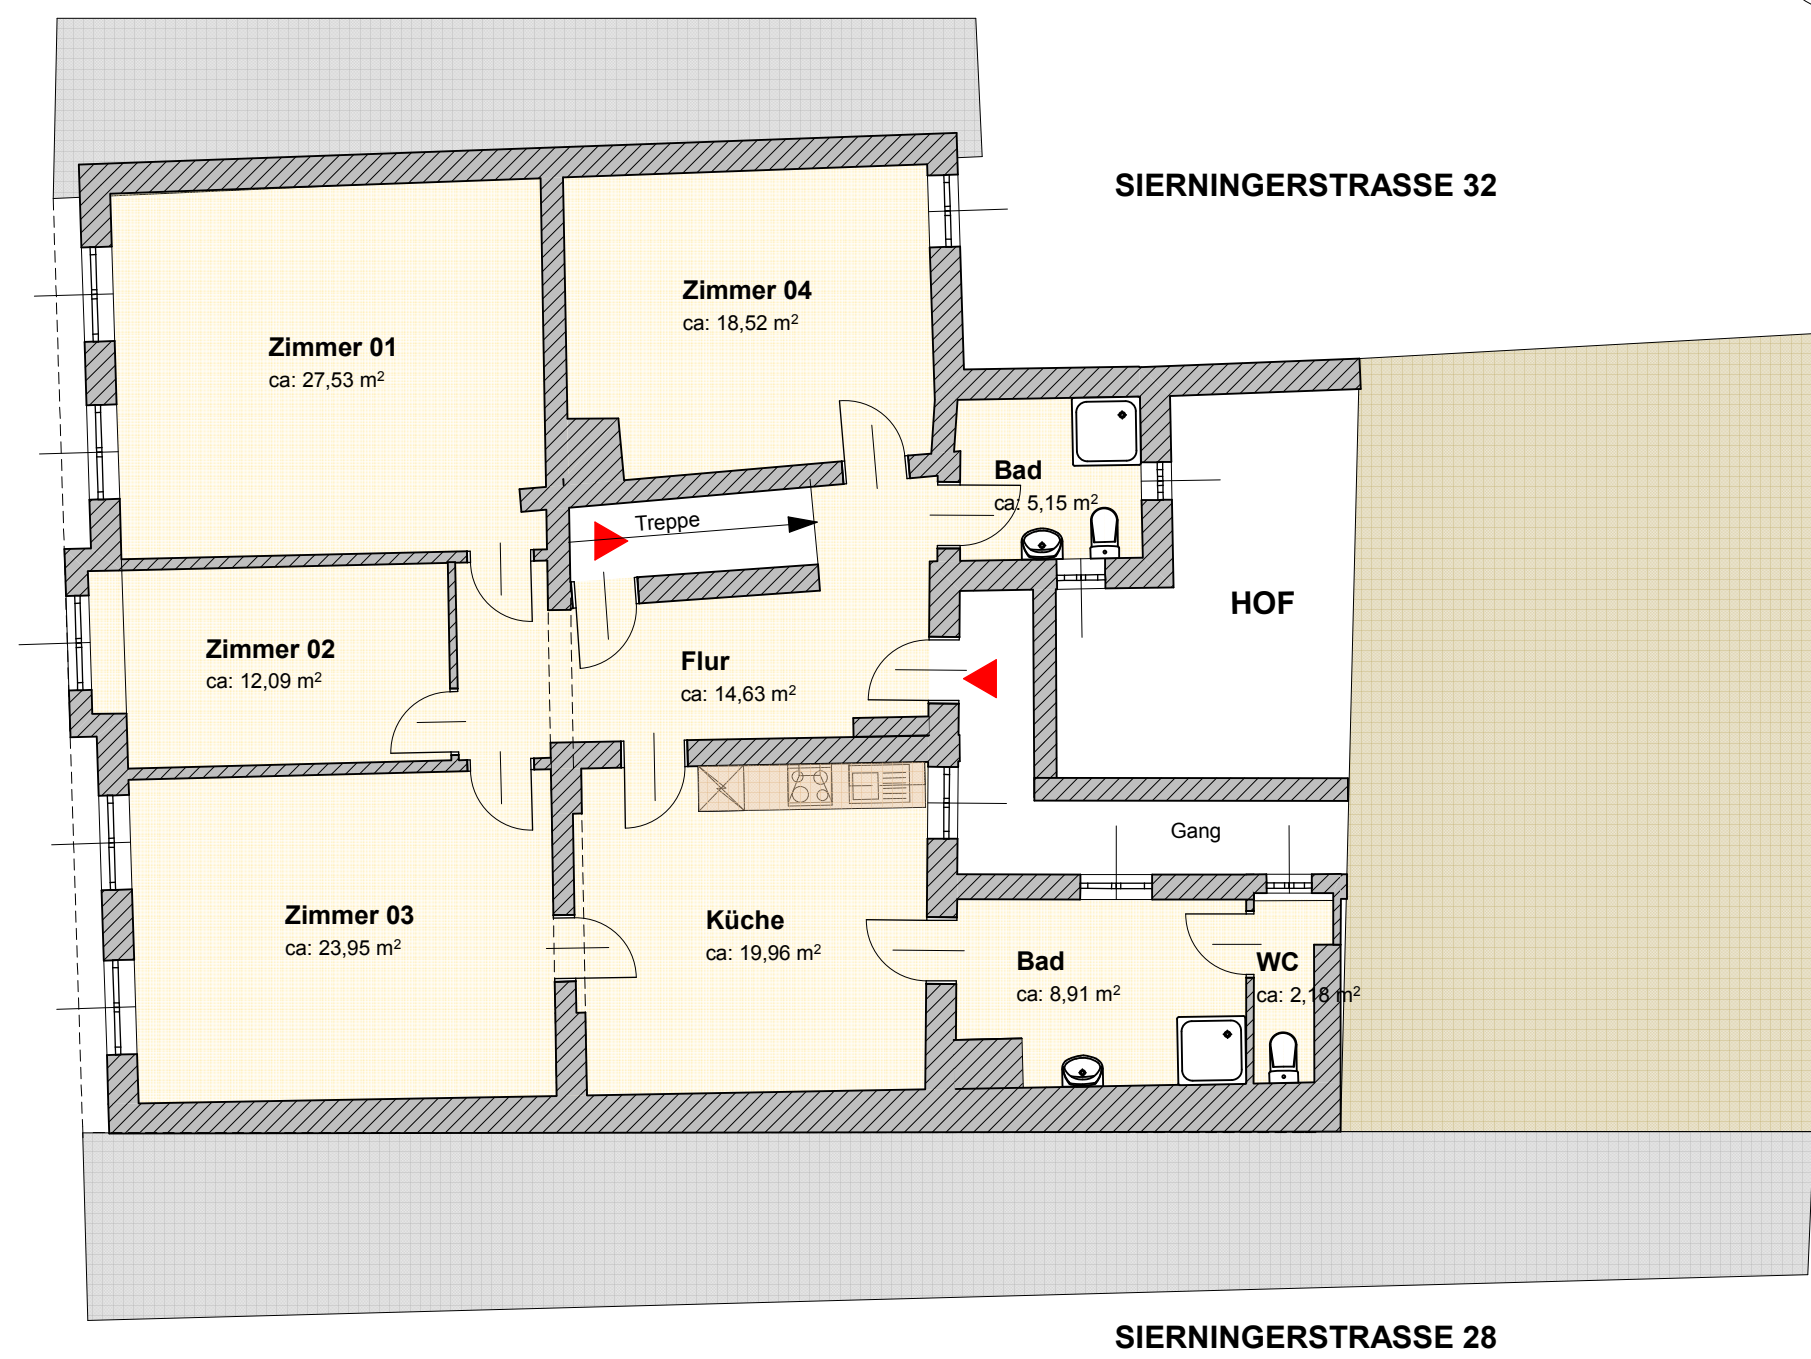

SIERNINGER STRASSE 30 4400 STEYR	
1.OBERGESCHOSS	TOP 02
GRUNDRISS	BESTANDSPLAN
M 1:100	08/10/2018